


O'TOOLE & COMPANY
Boston Massachusetts

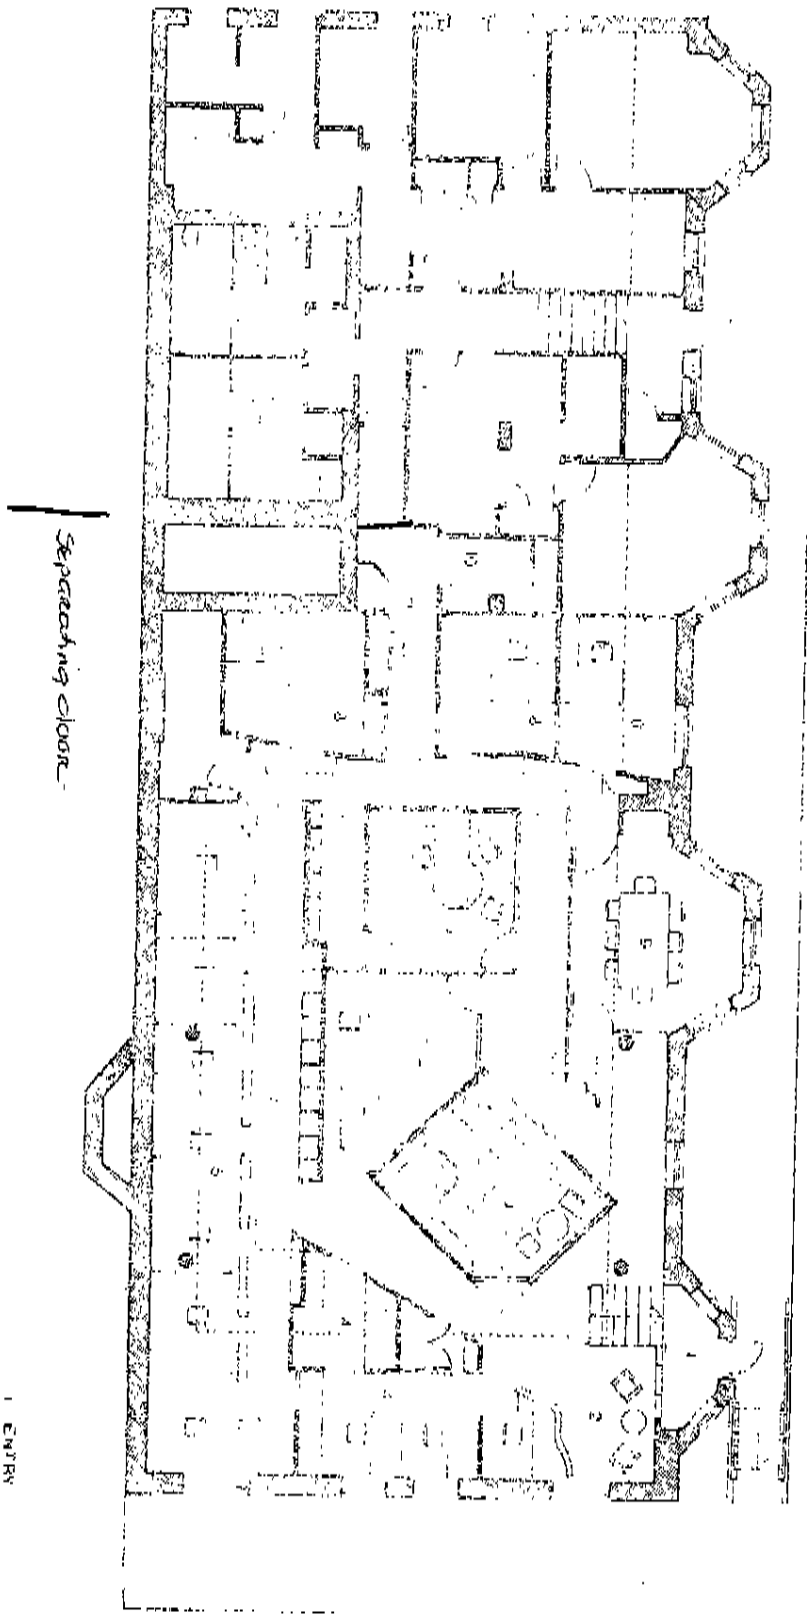

- 1 ENTRY
- 2 RECEPTION
- 3 ADMINISTRATION
- 4 SUPPORT FACILITIES
- 5 STAFF STATIONS
- 6 LIBRARY
- 7 PARTNERS OFFICES
- 8 SR. STAFF OFFICES
- 9 CONFERENCE ROOM
- 10 KITCHEN

P L A N

